



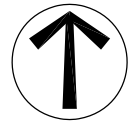

# 2901 WALL TRIANA. THIRD FLOOR PLAN

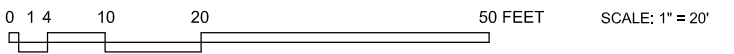

2903 Wall Triana Hwy Suite 7  
 Huntsville, AL 35824  
 256-461-7482  
 256-461-7427 fax  
[www.industrialpropertiesofthesouth.com](http://www.industrialpropertiesofthesouth.com)